
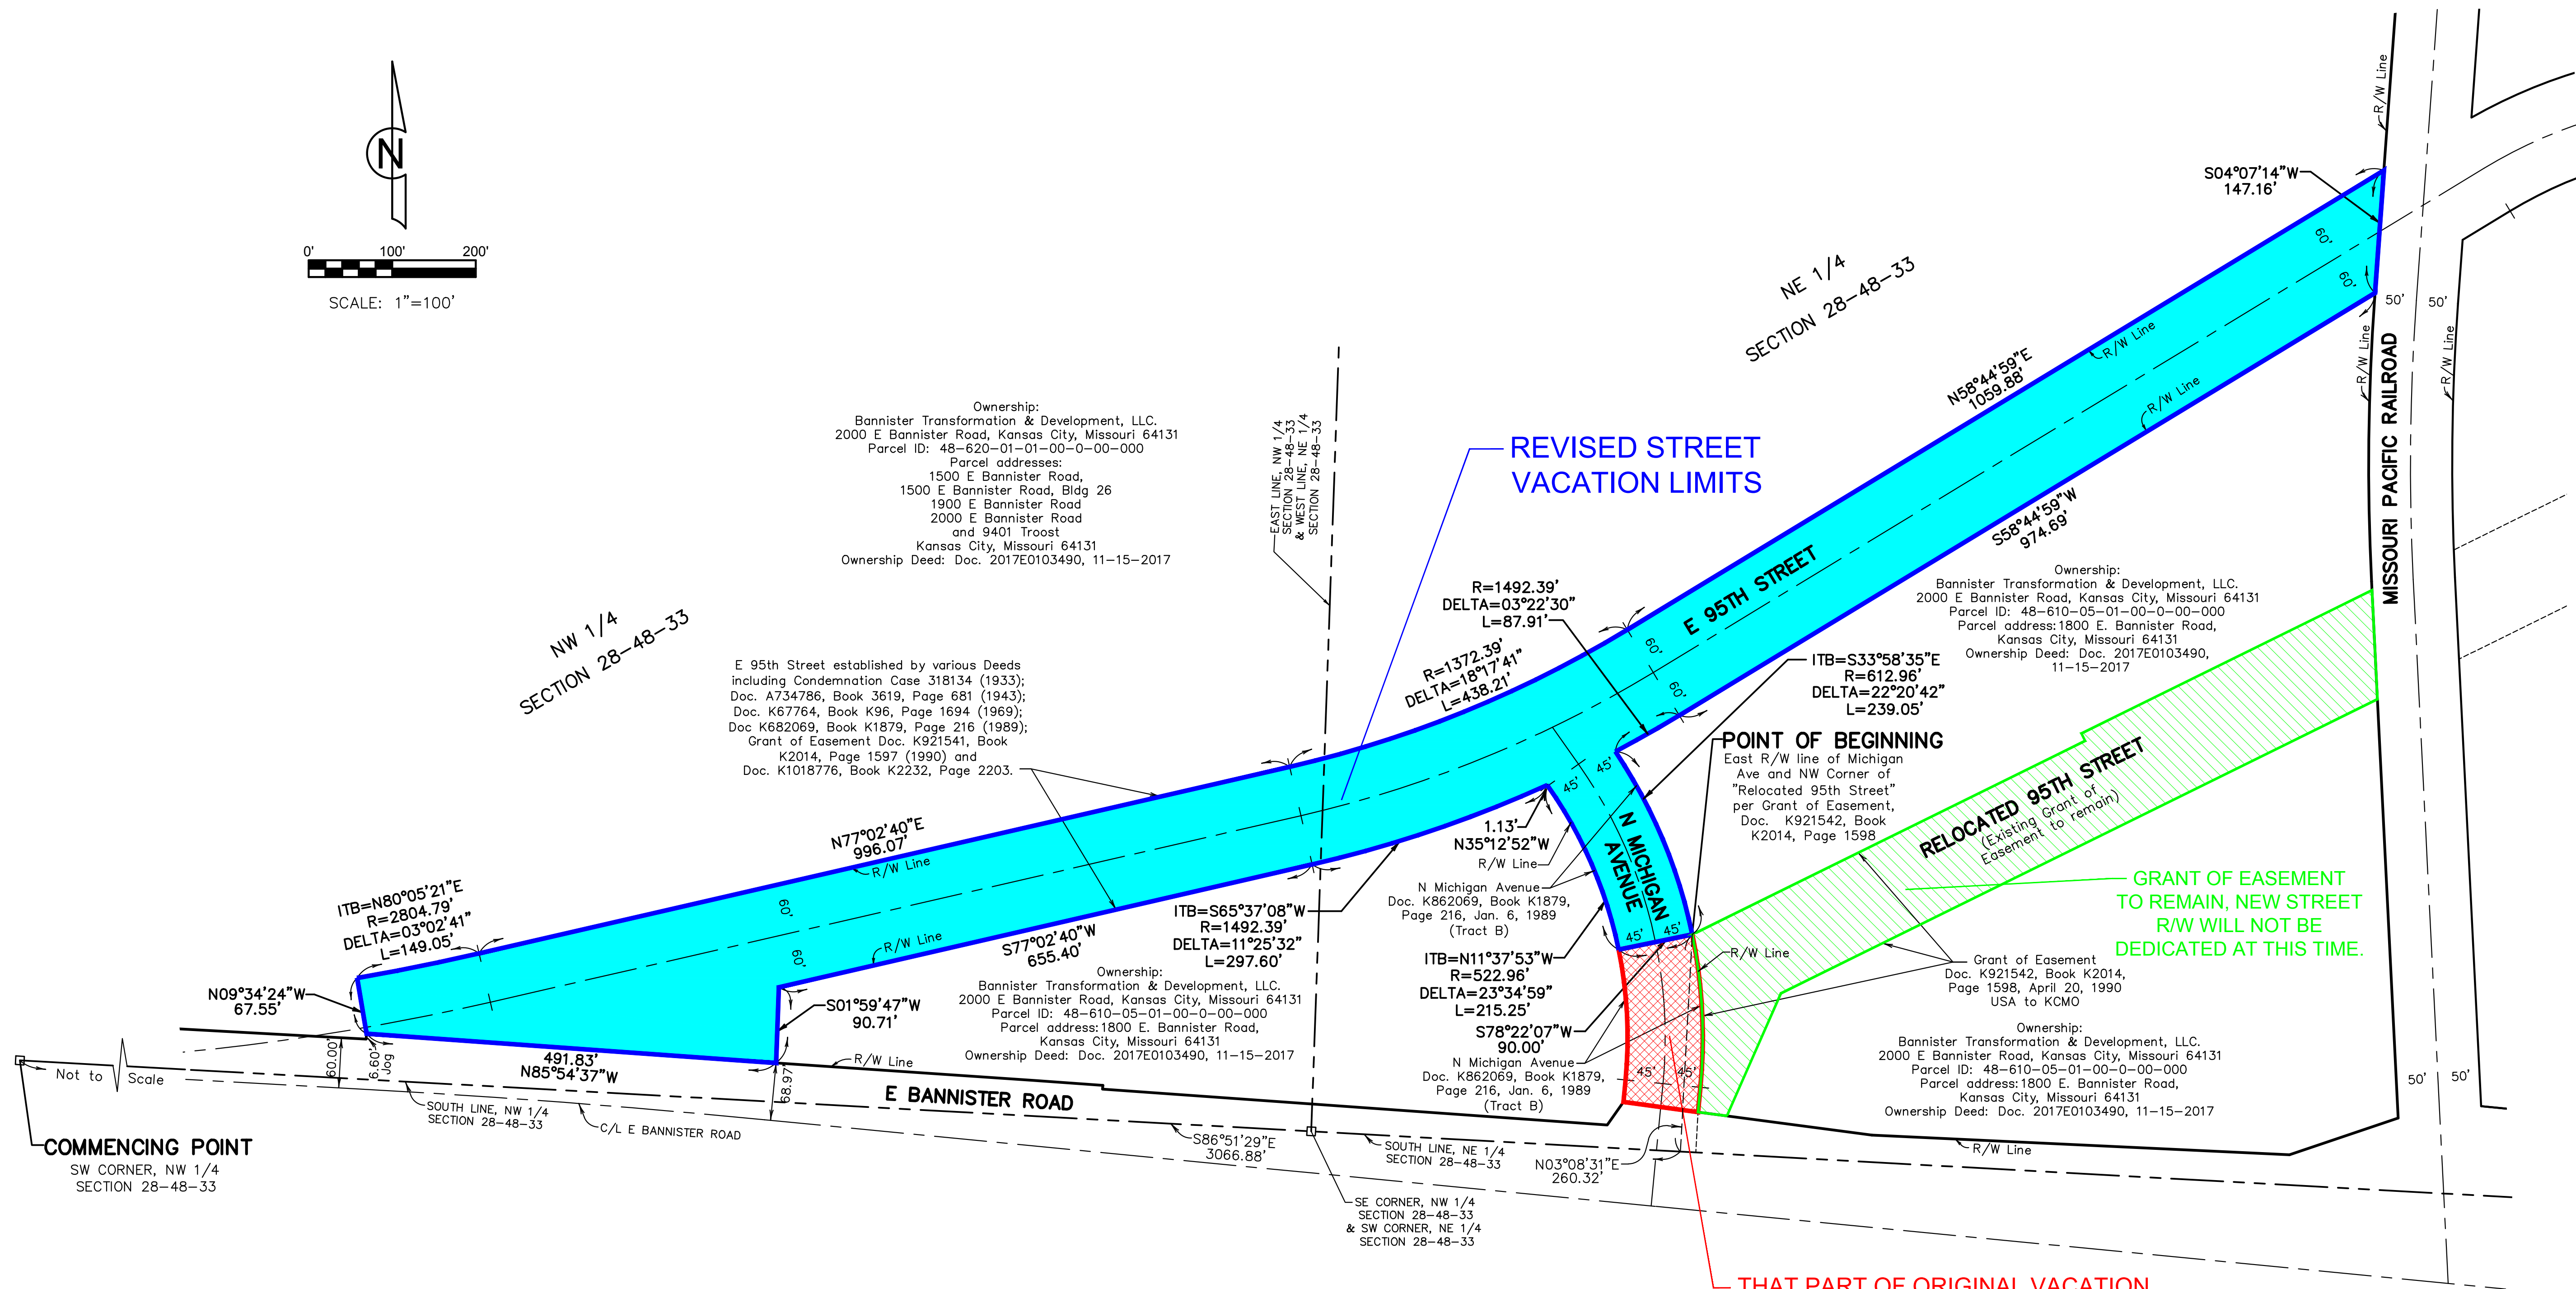


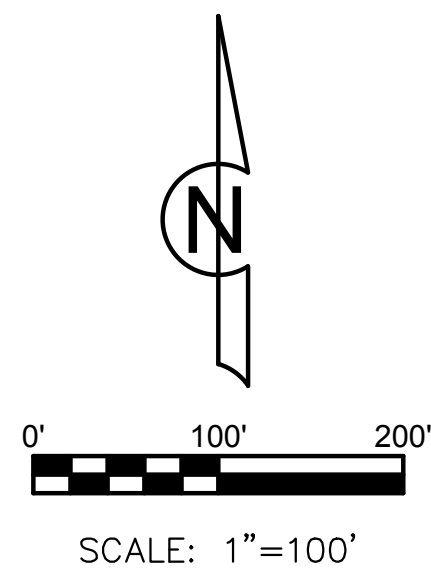

Location: F:\2017\0501-1000\017-0755\40-Design\Survey\SRVY\Sheets\Street Vacation\BC - 95th Street Vacation - REVISION EXHIBIT.dwg

Date of Survey: 03-12-2019 (Bal)

Revised to remove a small tract on the southerly end of N. Michigan Avenue from that part being dedicated to the street right of way. The tract is located at the intersection of E 95th Street and N. Michigan Avenue. The tract is shown in red on the map. The tract is to be removed from the street right of way and dedicated to the Grant of Easement for relocated 95th Street as established by Document K921542, in Book K2014 at Page 1598, recorded April 20, 1990. 03-03-2020

Surveyed By:

Reviewed By:

Drafted By:

Project:

Reference:

Projects:

#13091

#14137

Olsson

Olsson - Land Surveying - MO 366

1301 Burlington Street

North Kansas City, MO 64116

TEL 816.361.1177

FAX 816.361.1888

www.olsson.com

Sheet No:

1 of 1

EXHIBIT DRAWING

STREET VACATION

Part of E 95th Street
and N Michigan Avenue

BANNISTER COMPLEX

SEC. 28 - TWN. 48 - RNG. 33

KANSAS CITY, JACKSON COUNTY, MISSOURI